

SITE PLAN 1/8"=1'-0"


ASBUILT PLAN
NOT FOR CONSTRUCTION

AREA CALCS.:	
(E) ATTIC LEVEL LIVING AREA:	1862 S.F.
(E) SECOND LEVEL LIVING AREA:	2295 S.F.
(E) MAIN LEVEL LIVING AREA:	2240 S.F.
(E) BASEMENT LEVEL LIVING AREA:	1238+ S.F.
TOTAL LIVING AREA:	XXXX S.F.
(E) SECOND UNIT LIVING AREA:	664 S.F.
(E) SECOND UNIT PORCH AREA:	95 S.F.
(E) MAIN LEVEL PORCH AREA:	320 S.F.
(E) SECOND LEVEL DECK AREA:	298 S.F.
(E) SITE AREA:	13,609 S.F.

Revisions:	Date:	By:


GREGORY A. PEITZ
ARCHITECT
383 Rio Lindo Ave. Chico, CA. 95926 (530) 894- 5719

ROMODEL FRATERNITY HOUSE
THETA CHI
for:
at:
630 WEST 5th. STREET
CHICO, CALIF. 95928

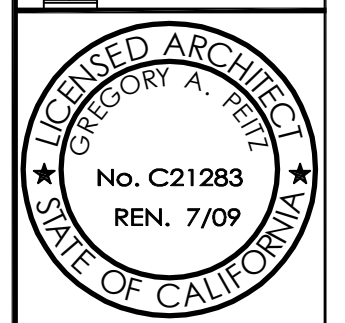


THETA CHI
REMODEL


Date: 12/14/08
Scale:
Drawn: DAVID S.
Job: 08-1292
Sheet:
1
of three Sheets

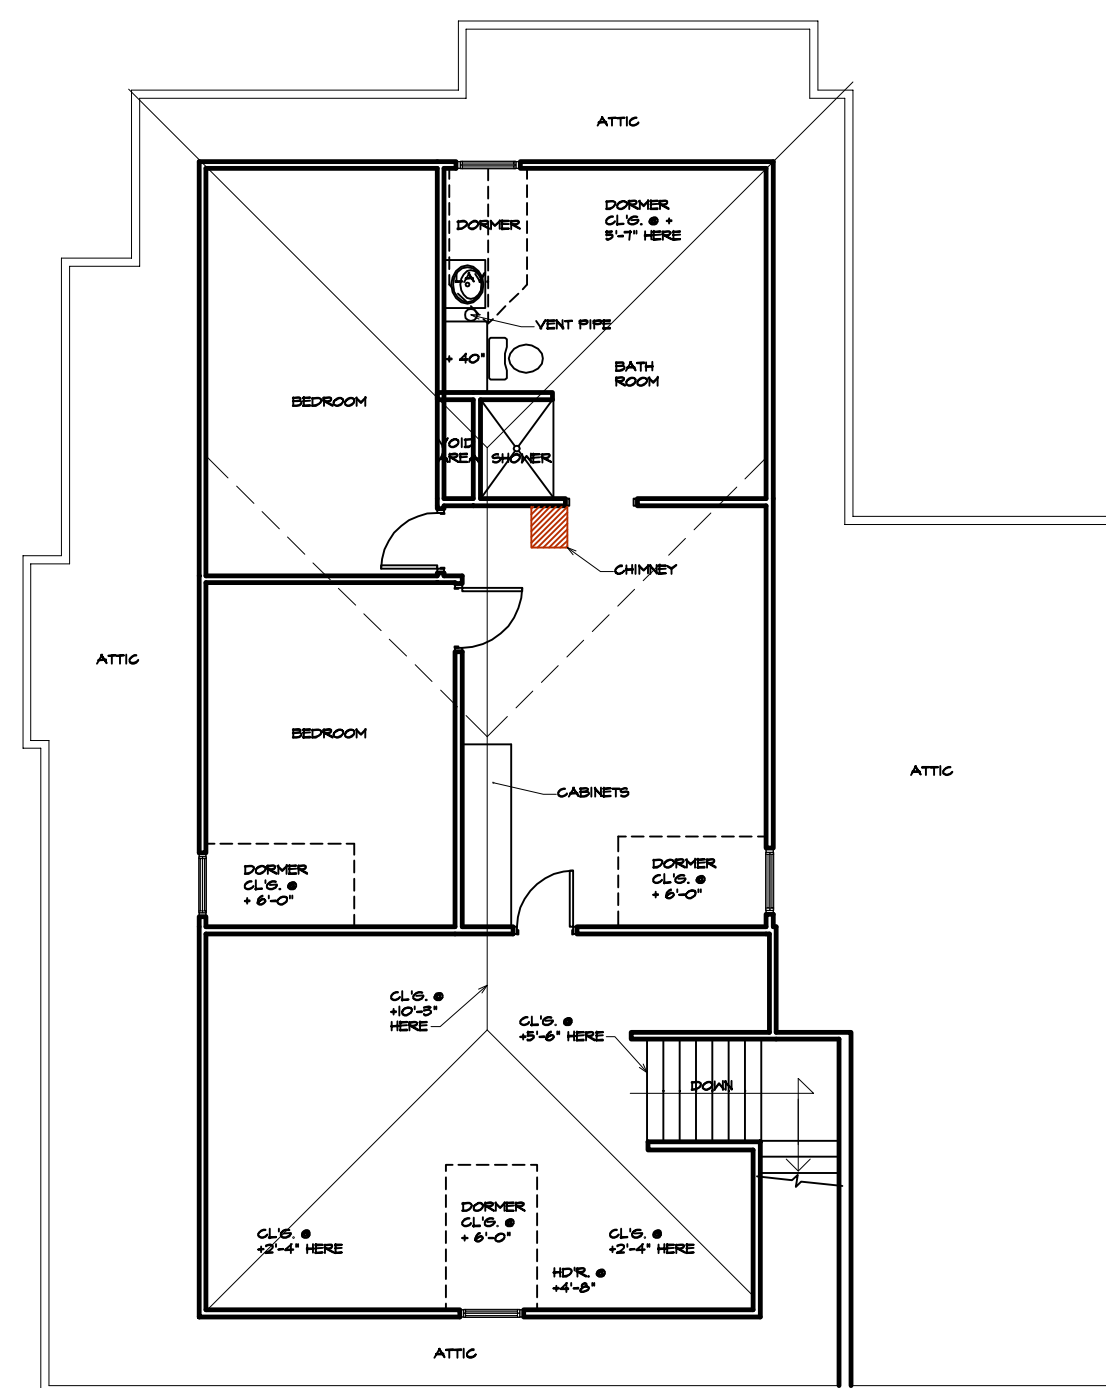


ATTIC LEVEL FLOOR PLAN 1/8"=1'-0"

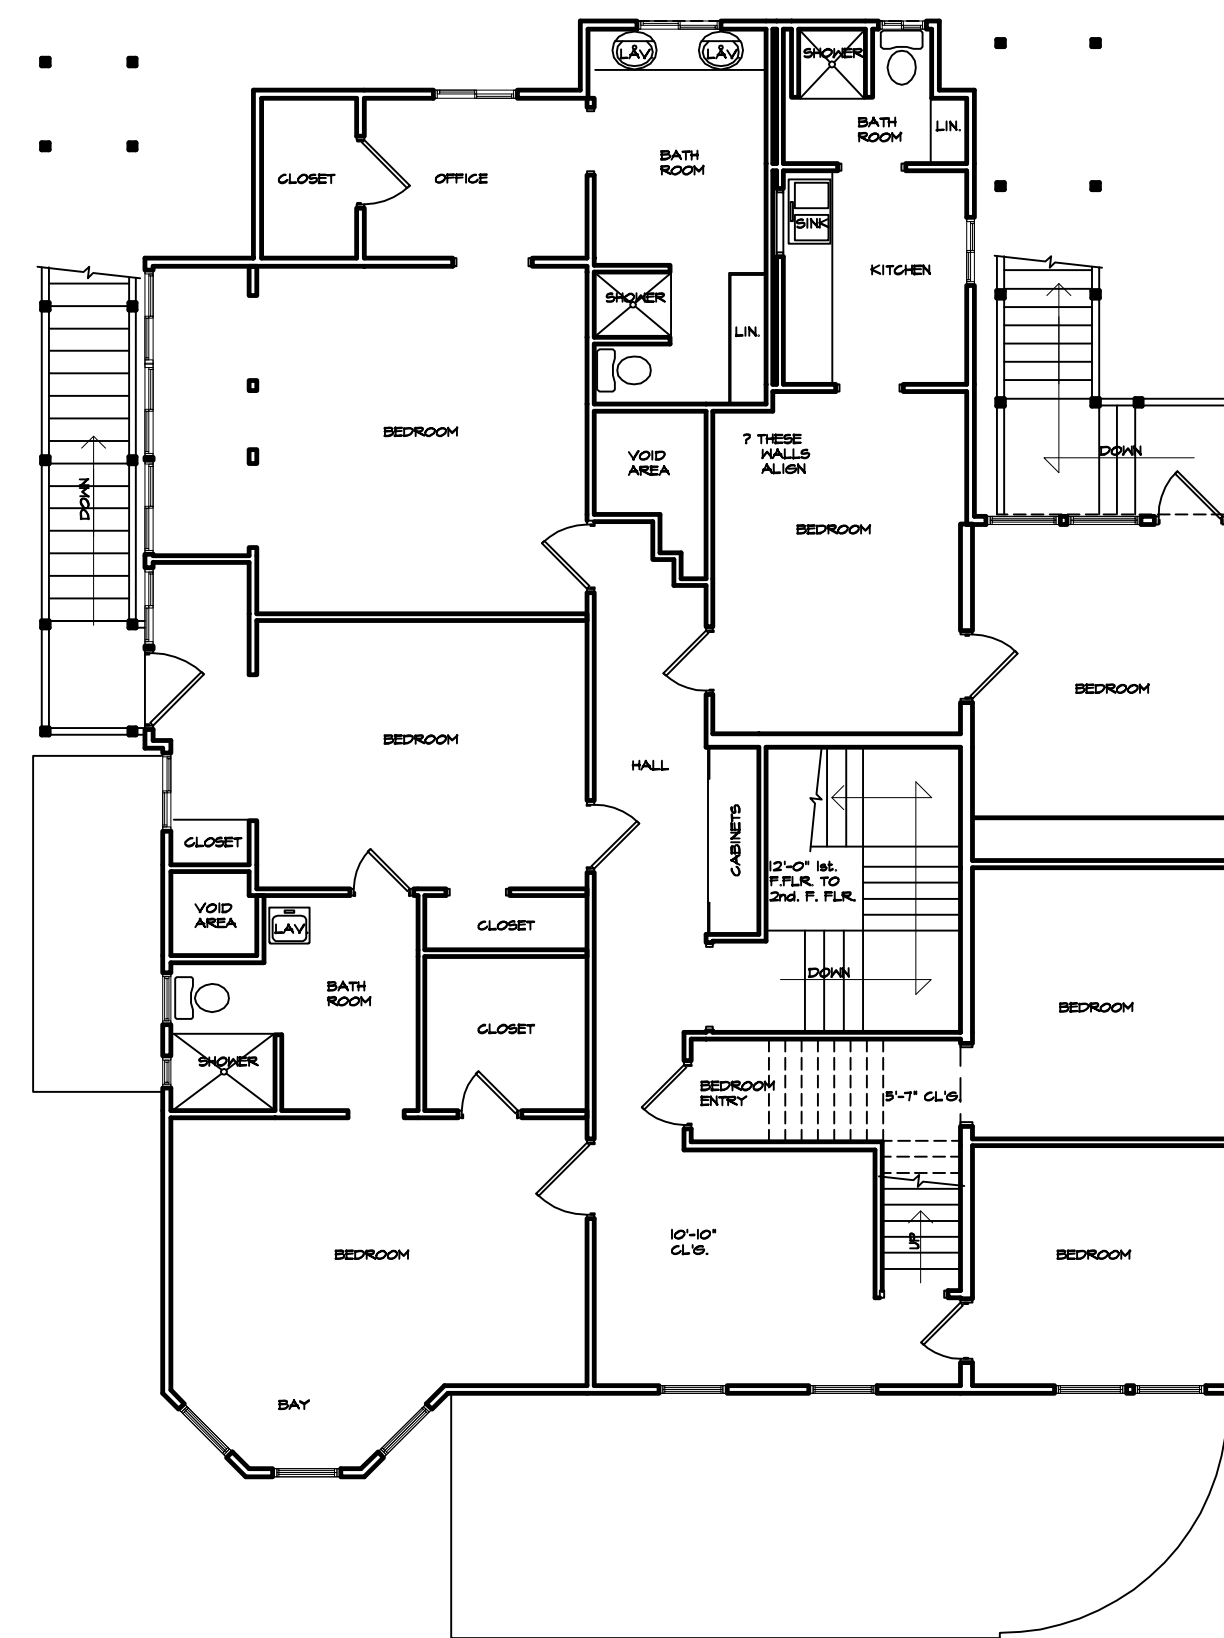

SECOND LEVEL FLOOR PLAN 1/8"=1'-0"

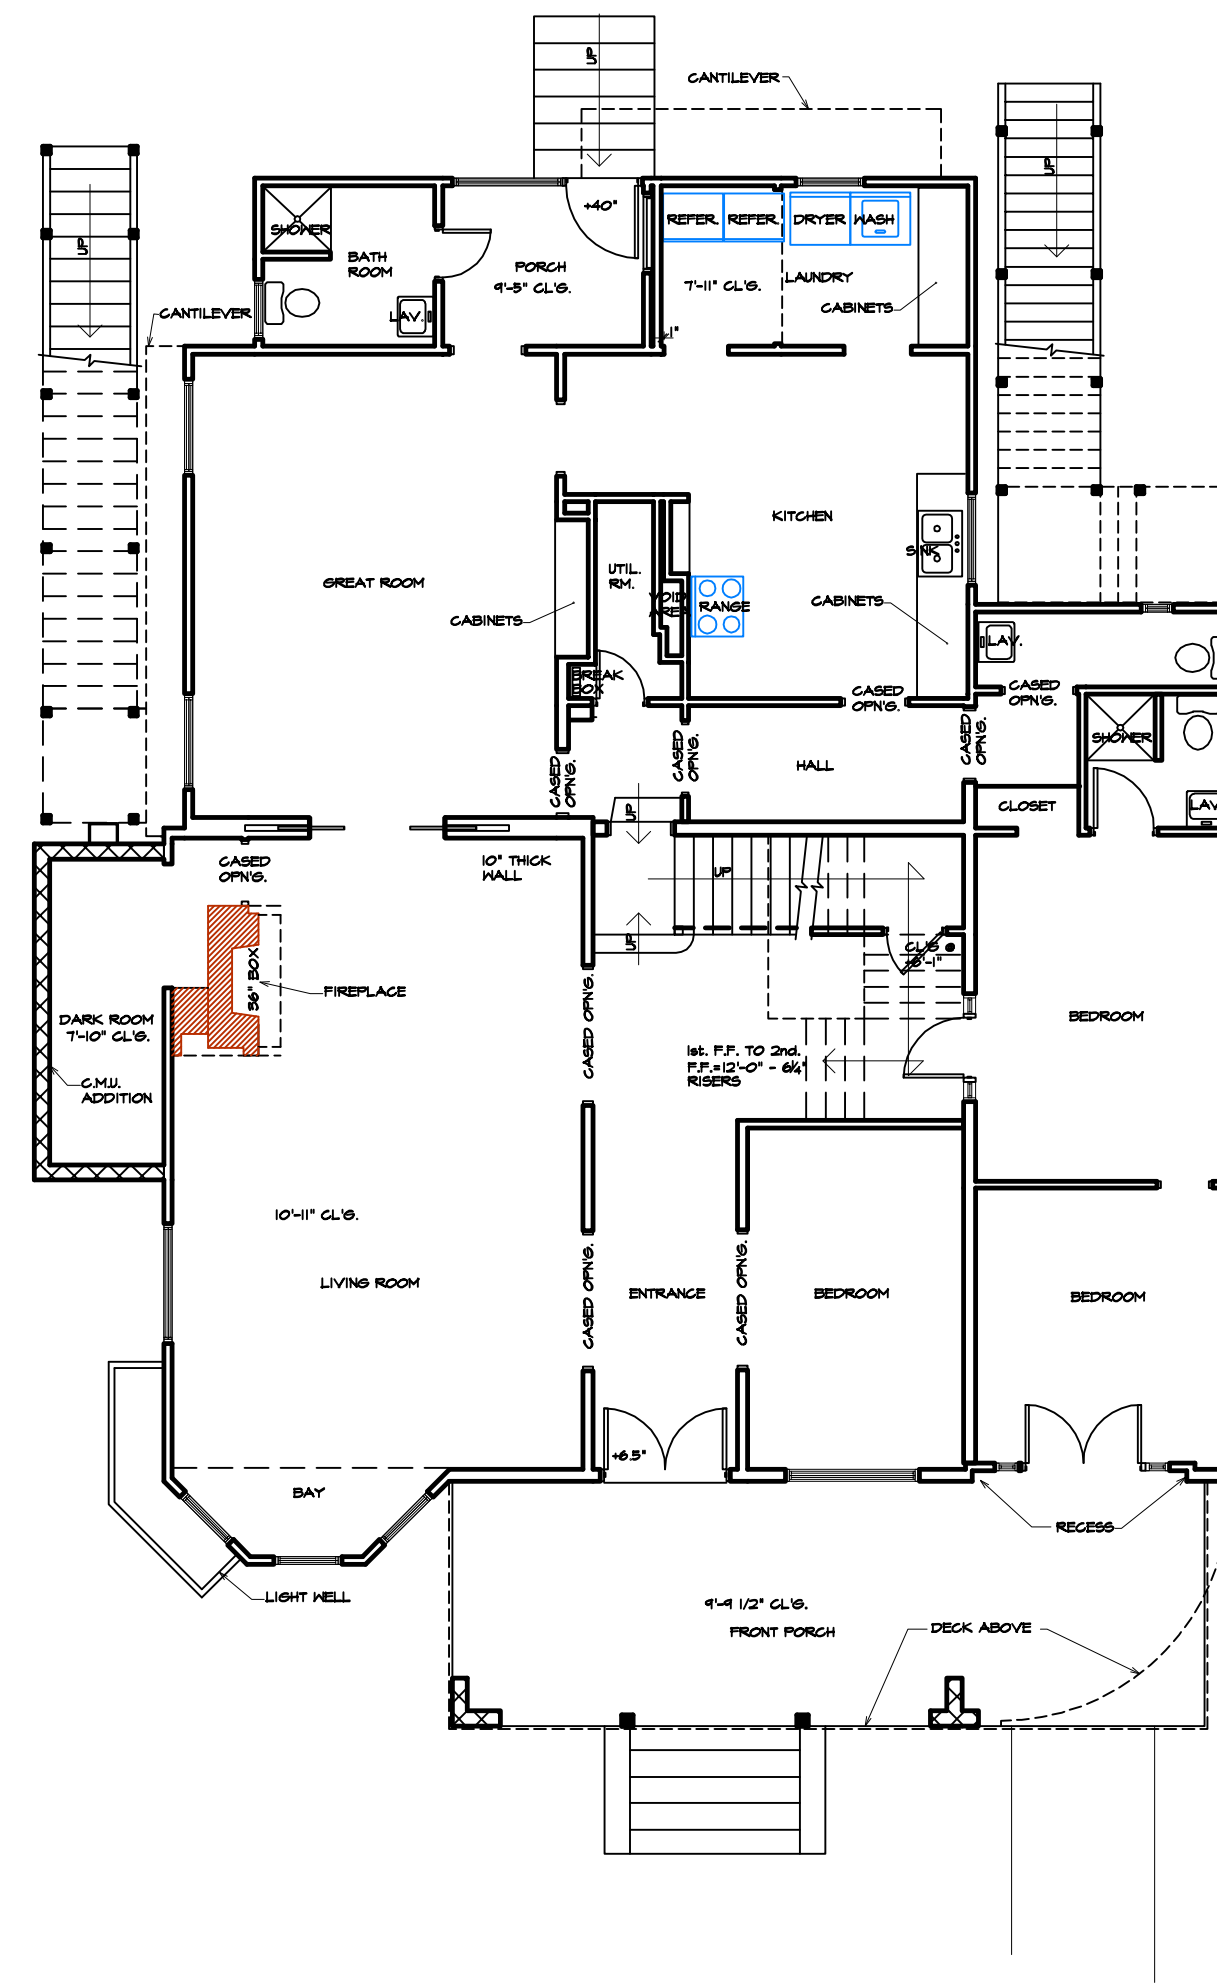


MAIN LEVEL FLOOR PLAN 1/8"=1'-0"

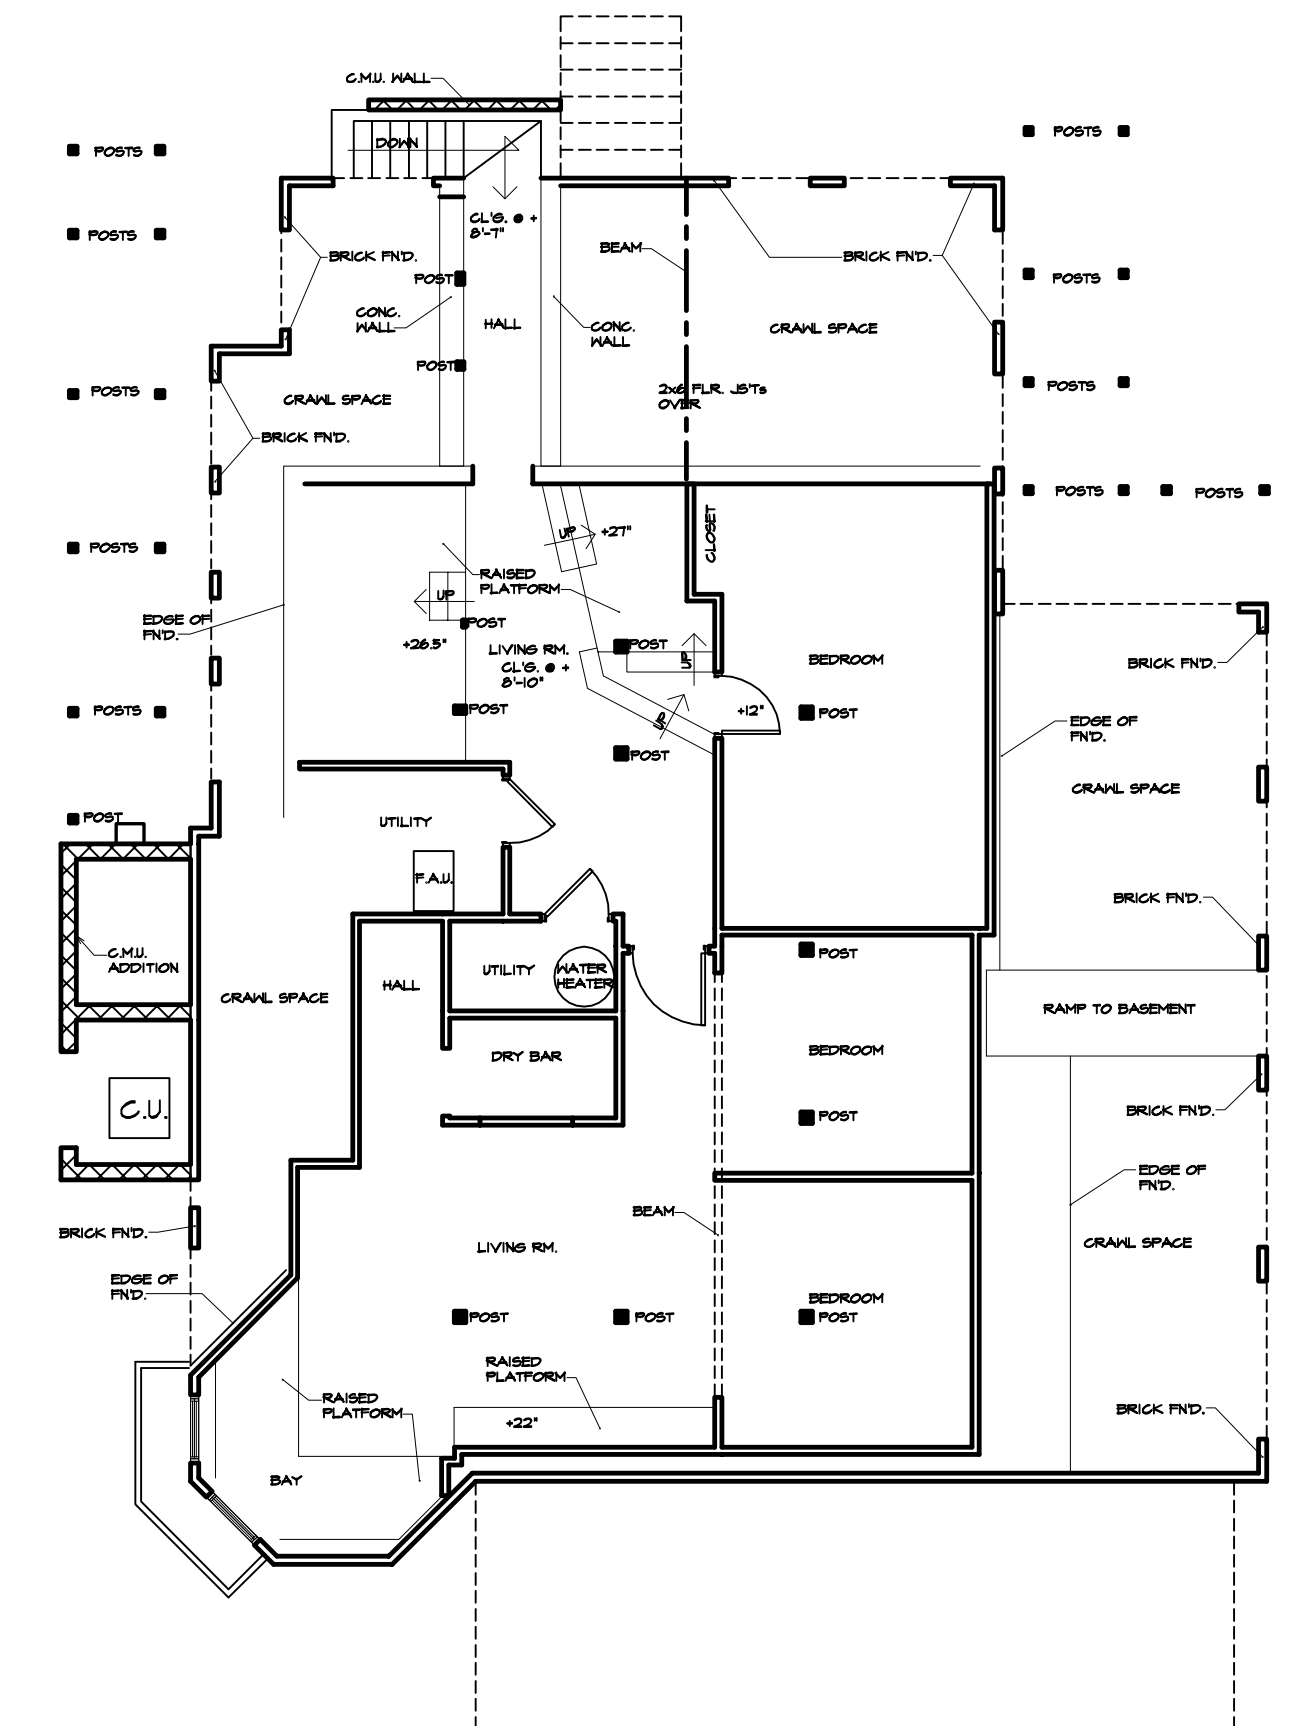


BASEMENT FLOOR PLAN 1/8"=1'-0"

ASBUILT PLAN
NOT FOR CONSTRUCTION

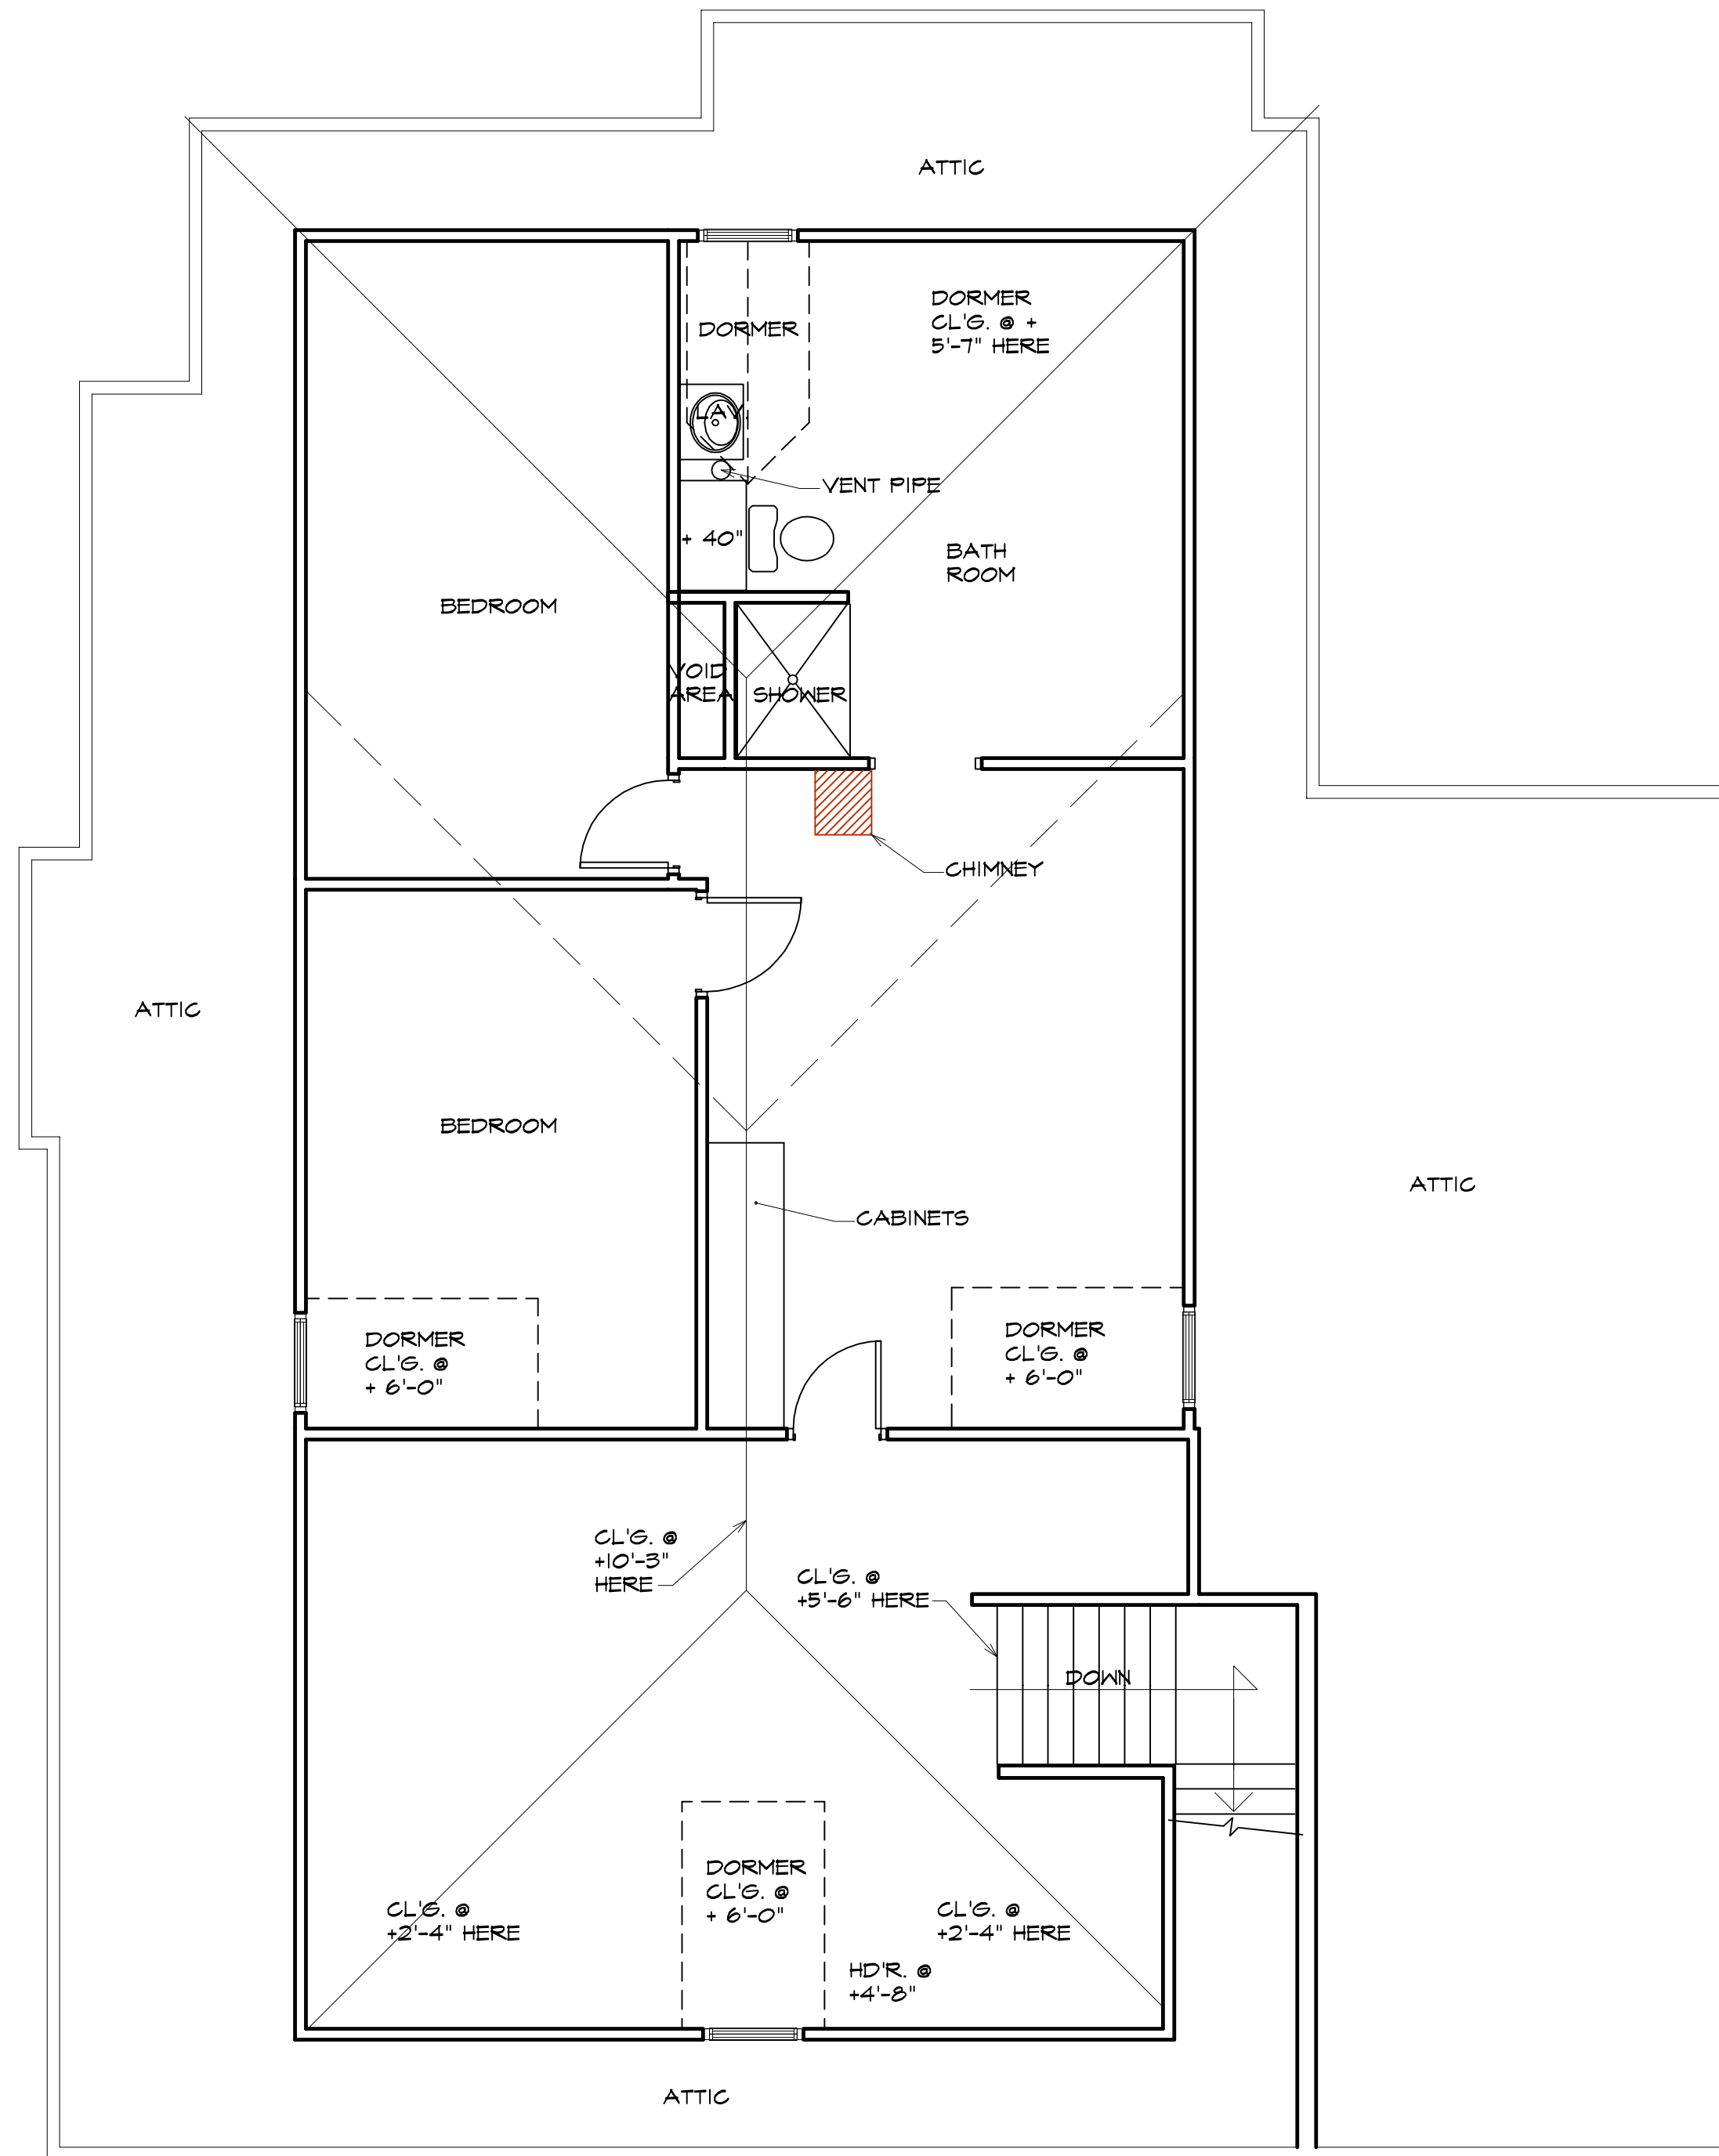

ATTIC FLOOR PLAN 1/4"=1'-0"

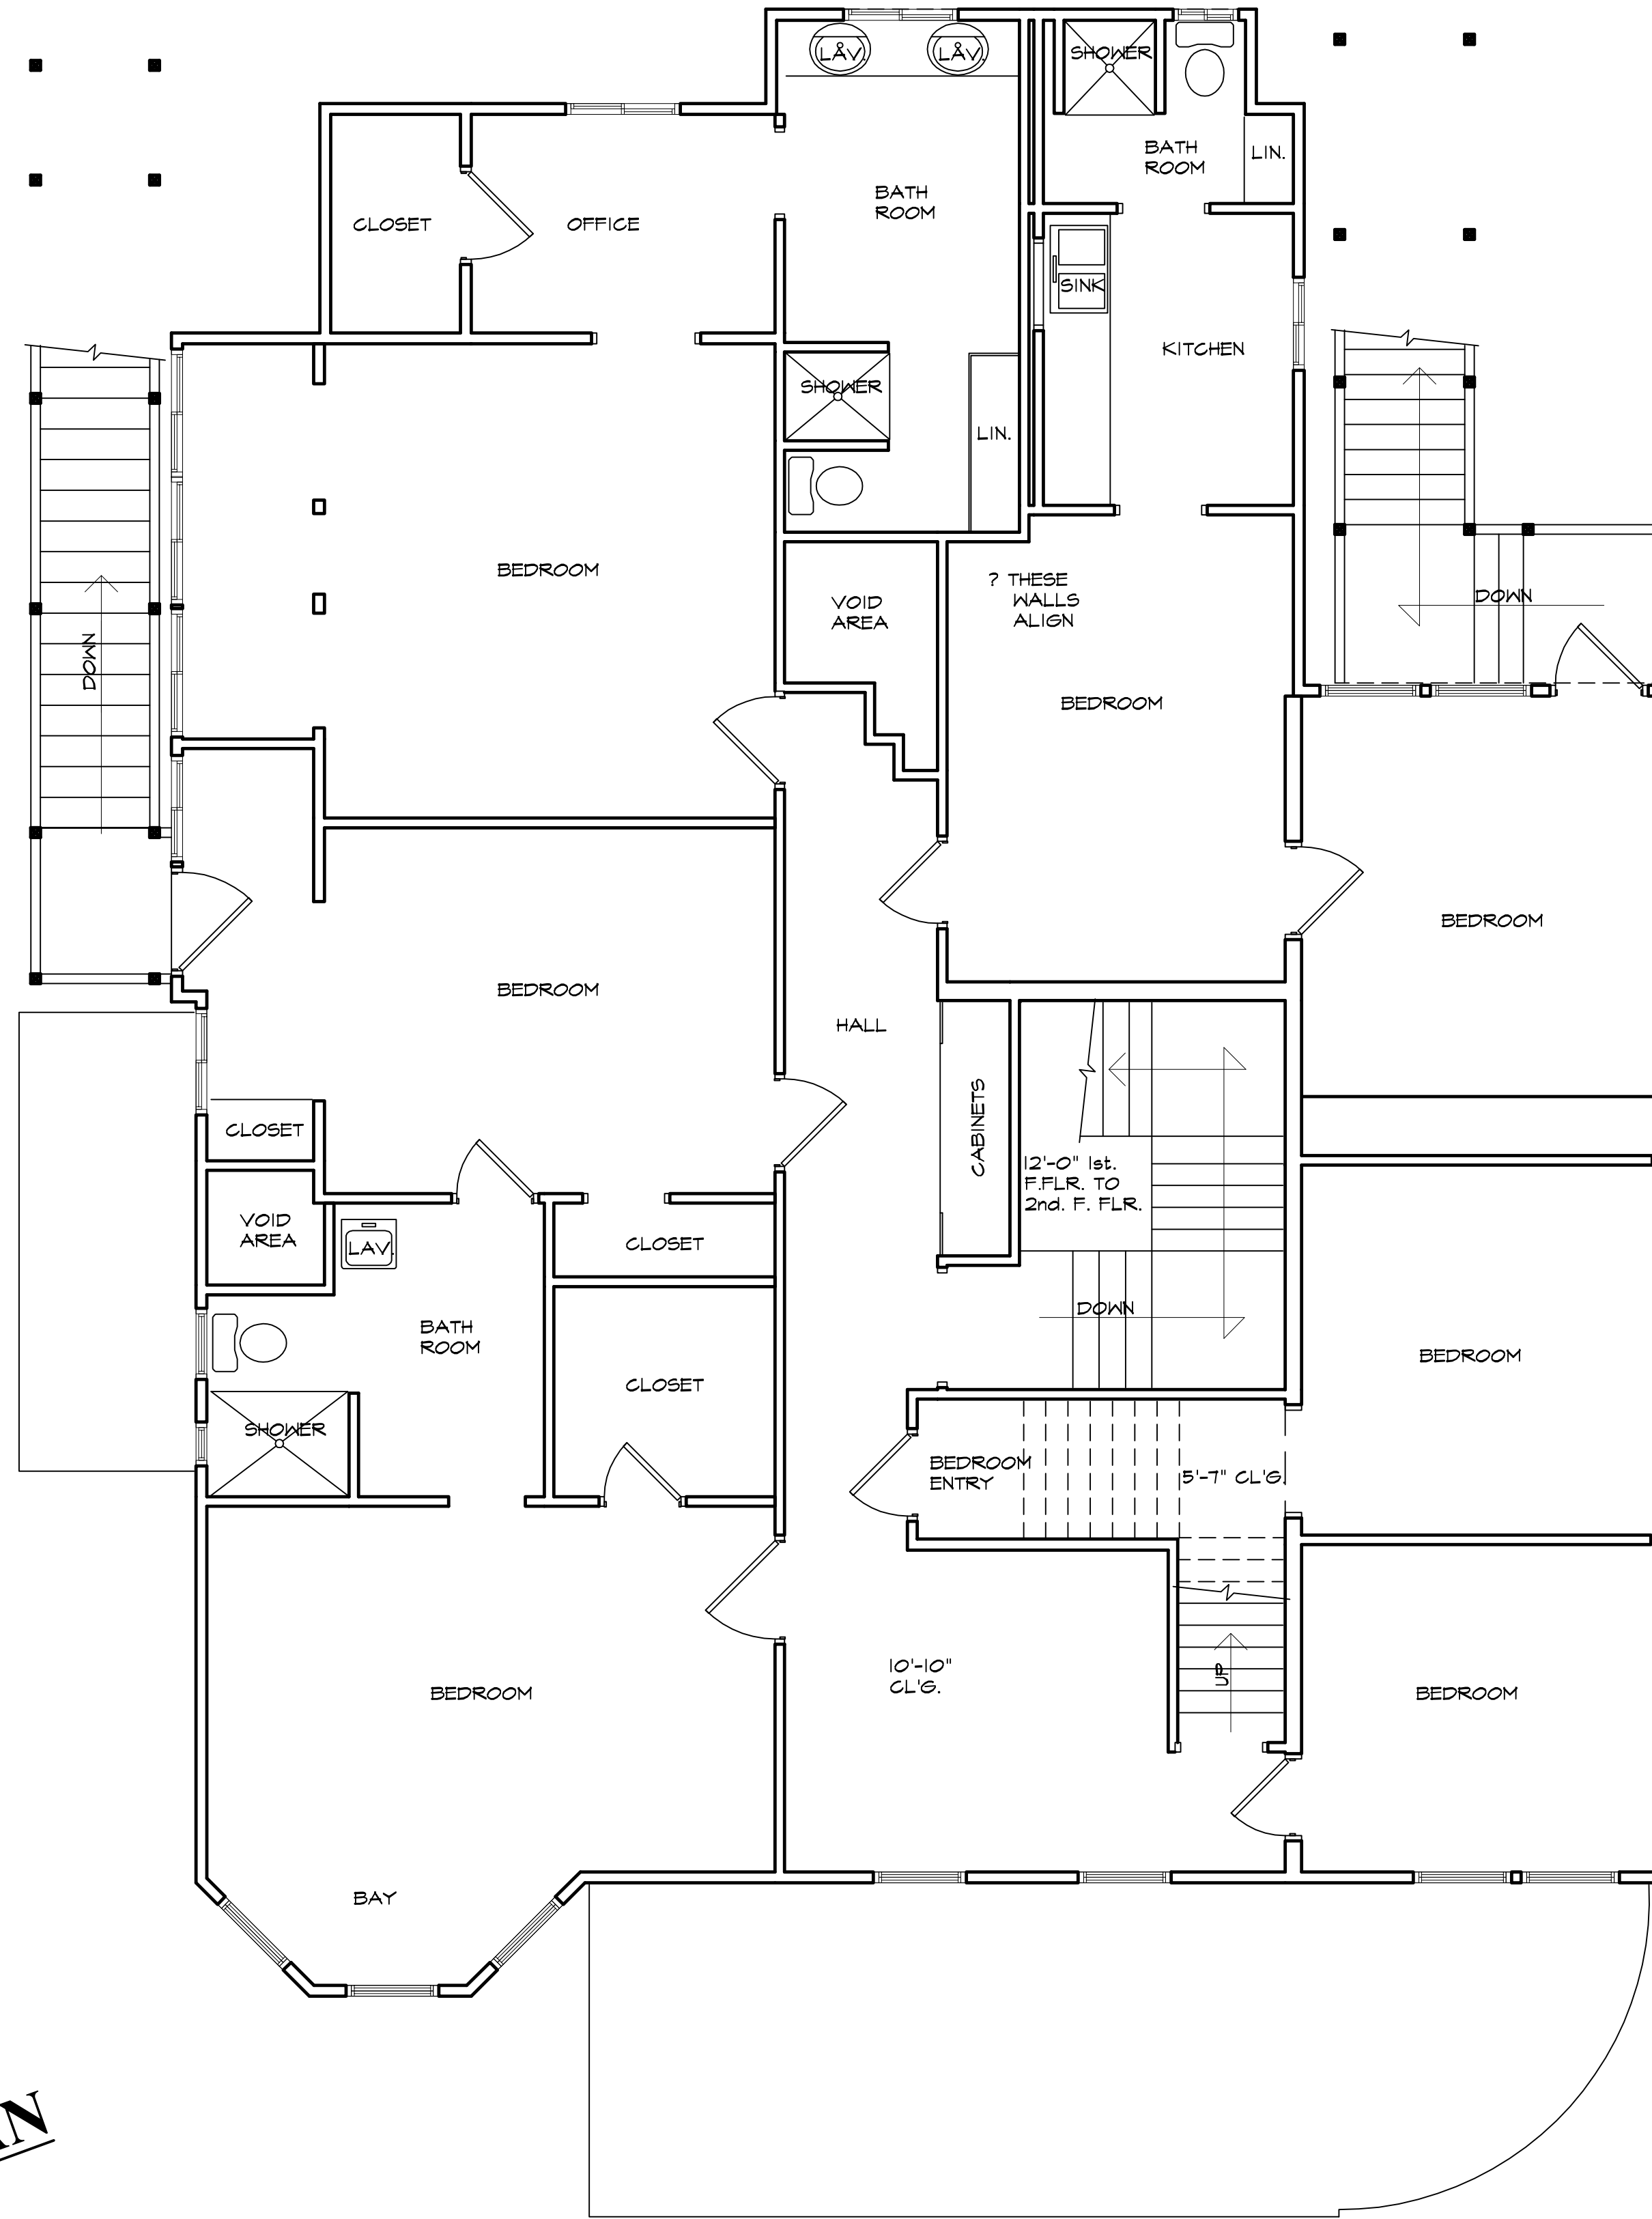


SECOND LEVEL FLOOR PLAN

ASBUILT PLAN
NOT FOR CONSTRUCTION

Revisions:	Date:	By:

GREGORY A. PEITZ
ARCHITECT
383 Rio Lindo Ave. Chico, CA. 95926 (530) 894- 5719


ROMODEL FRATERNITY HOUSE
THETA CHI
for: 630 WEST 5th. STREET
at: CHICO, CALIF. 95928

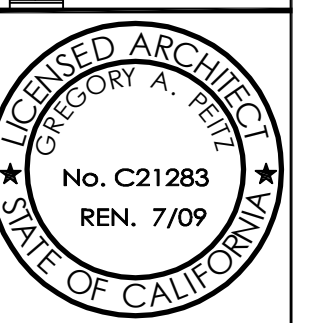

THETA CHI
REMODEL


Date: 12/14/08
Scale:
Drawn: DAVID S.
Job: 08-1292

Sheet:
3
Of three Sheets

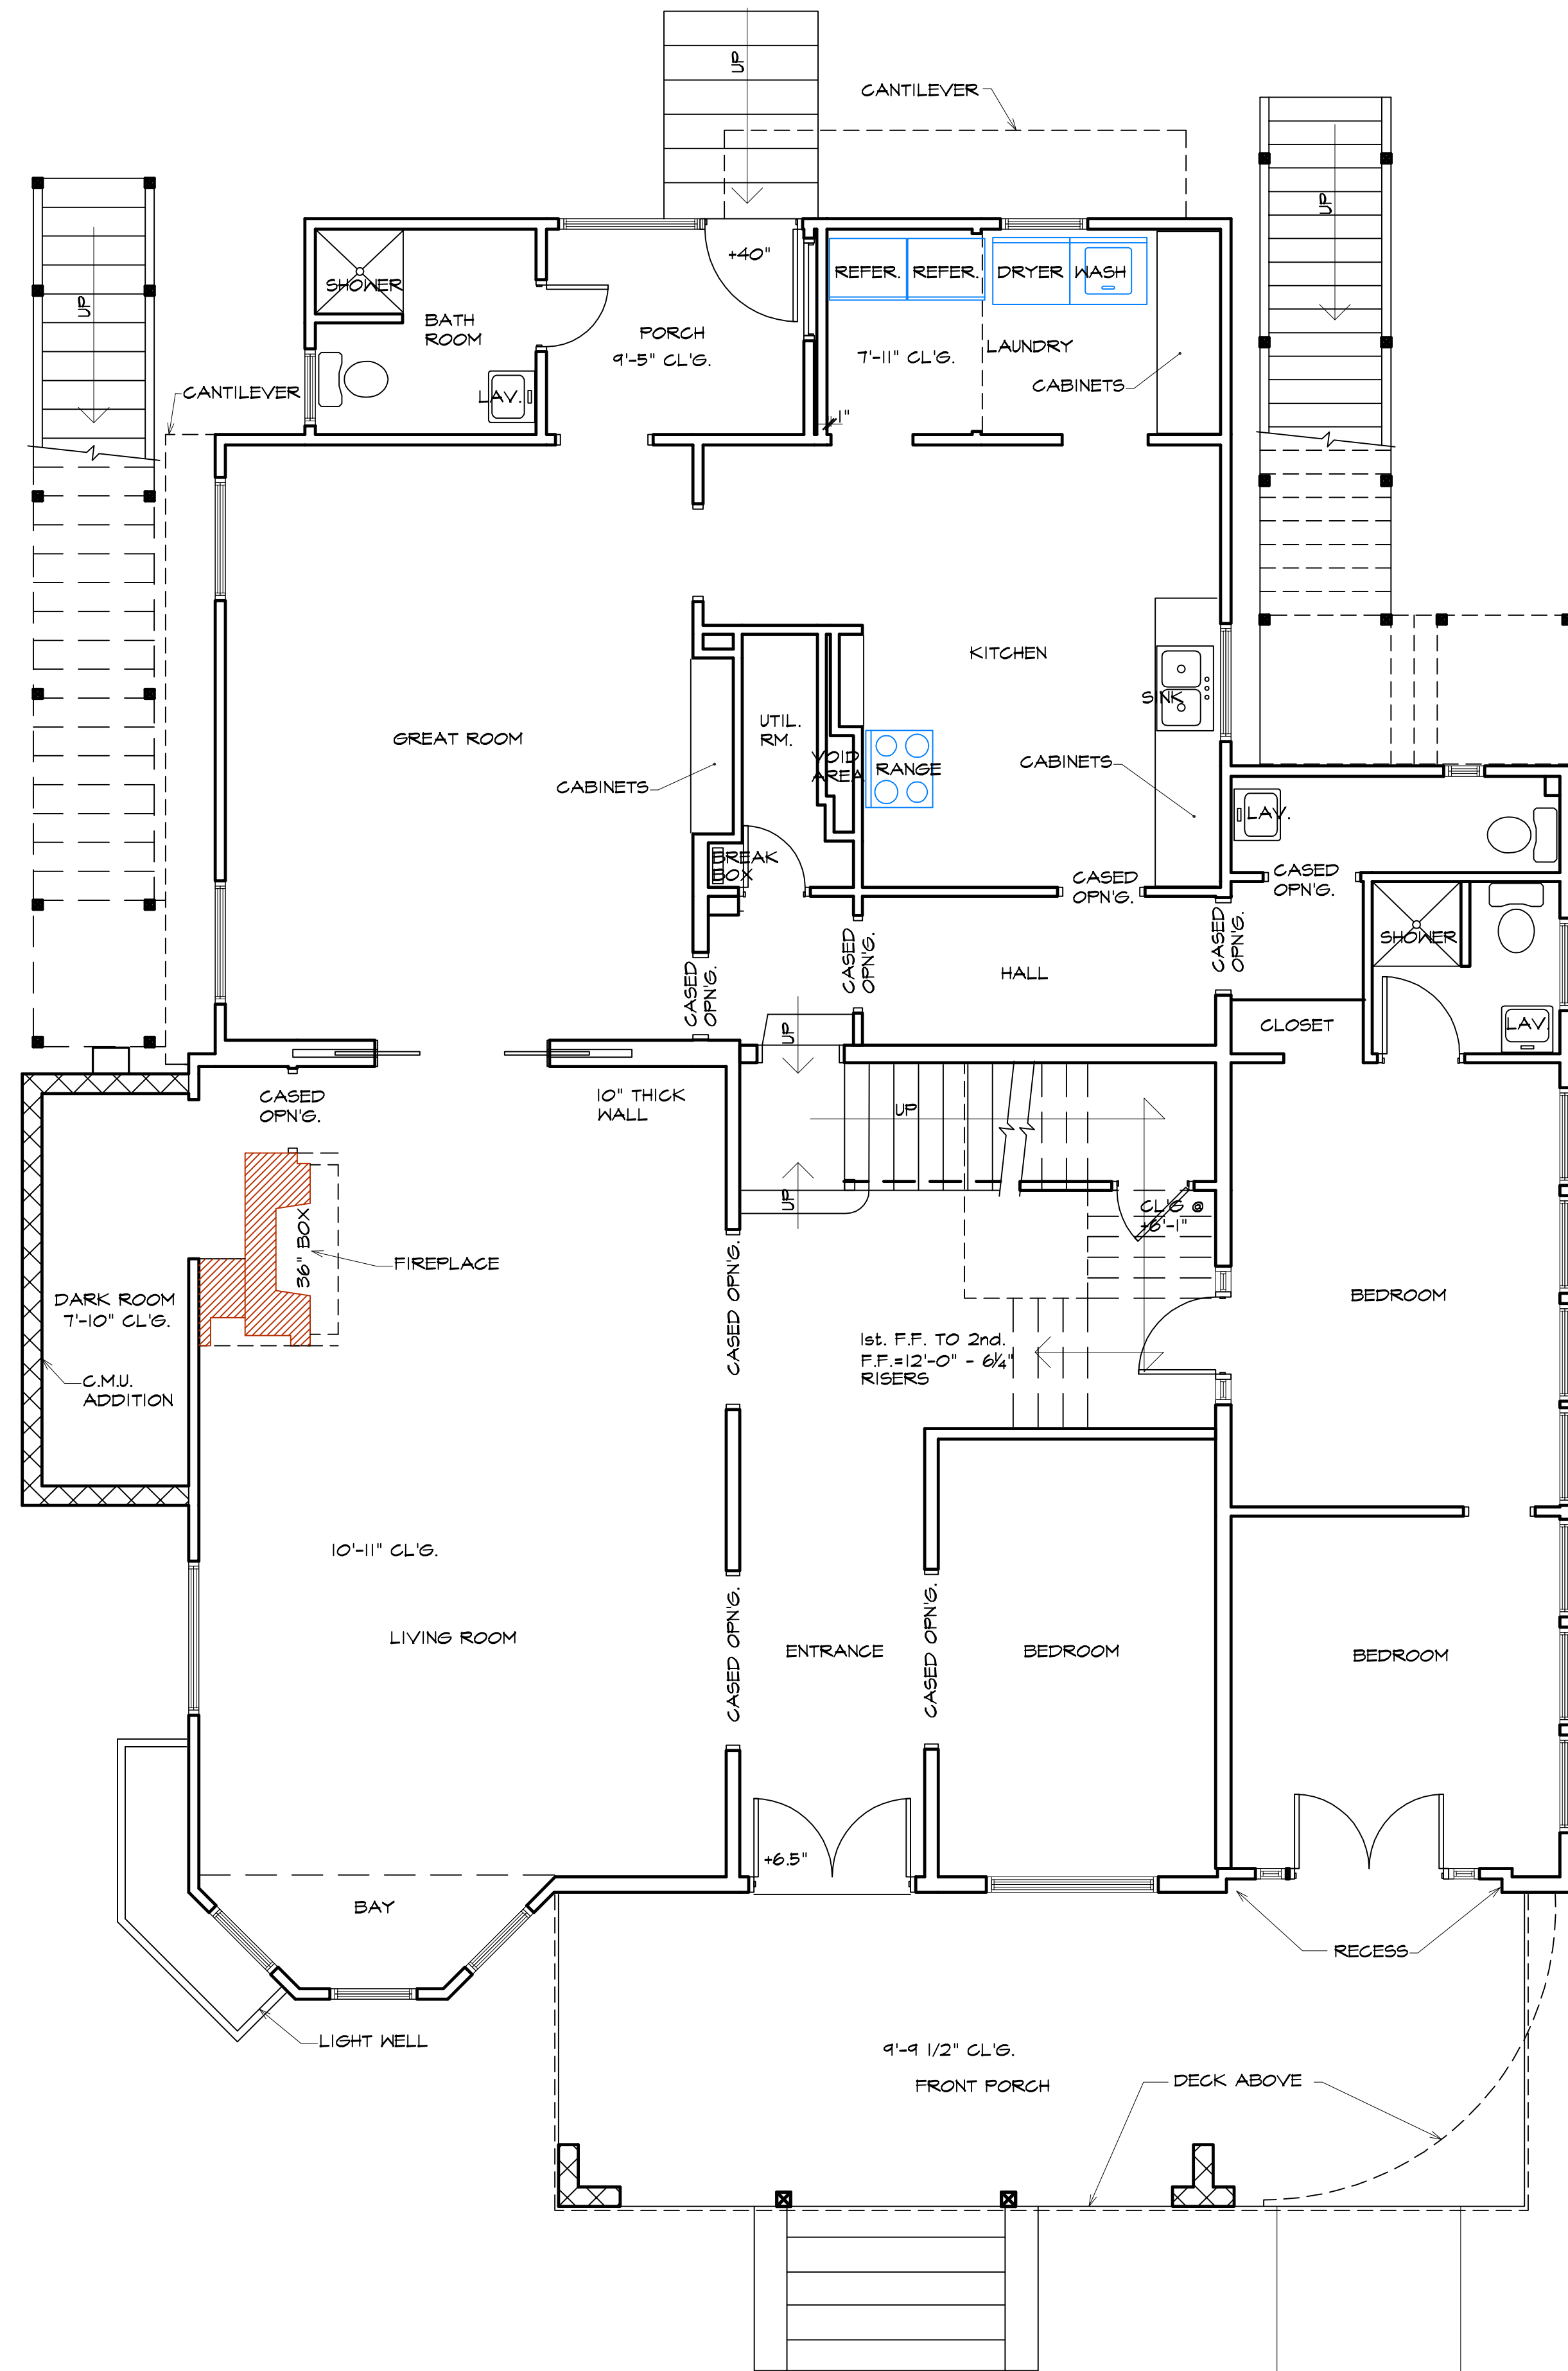

MAIN LEVEL FLOOR PLAN 1/4"=1'-0"

ASBUILT PLAN
NOT FOR CONSTRUCTION

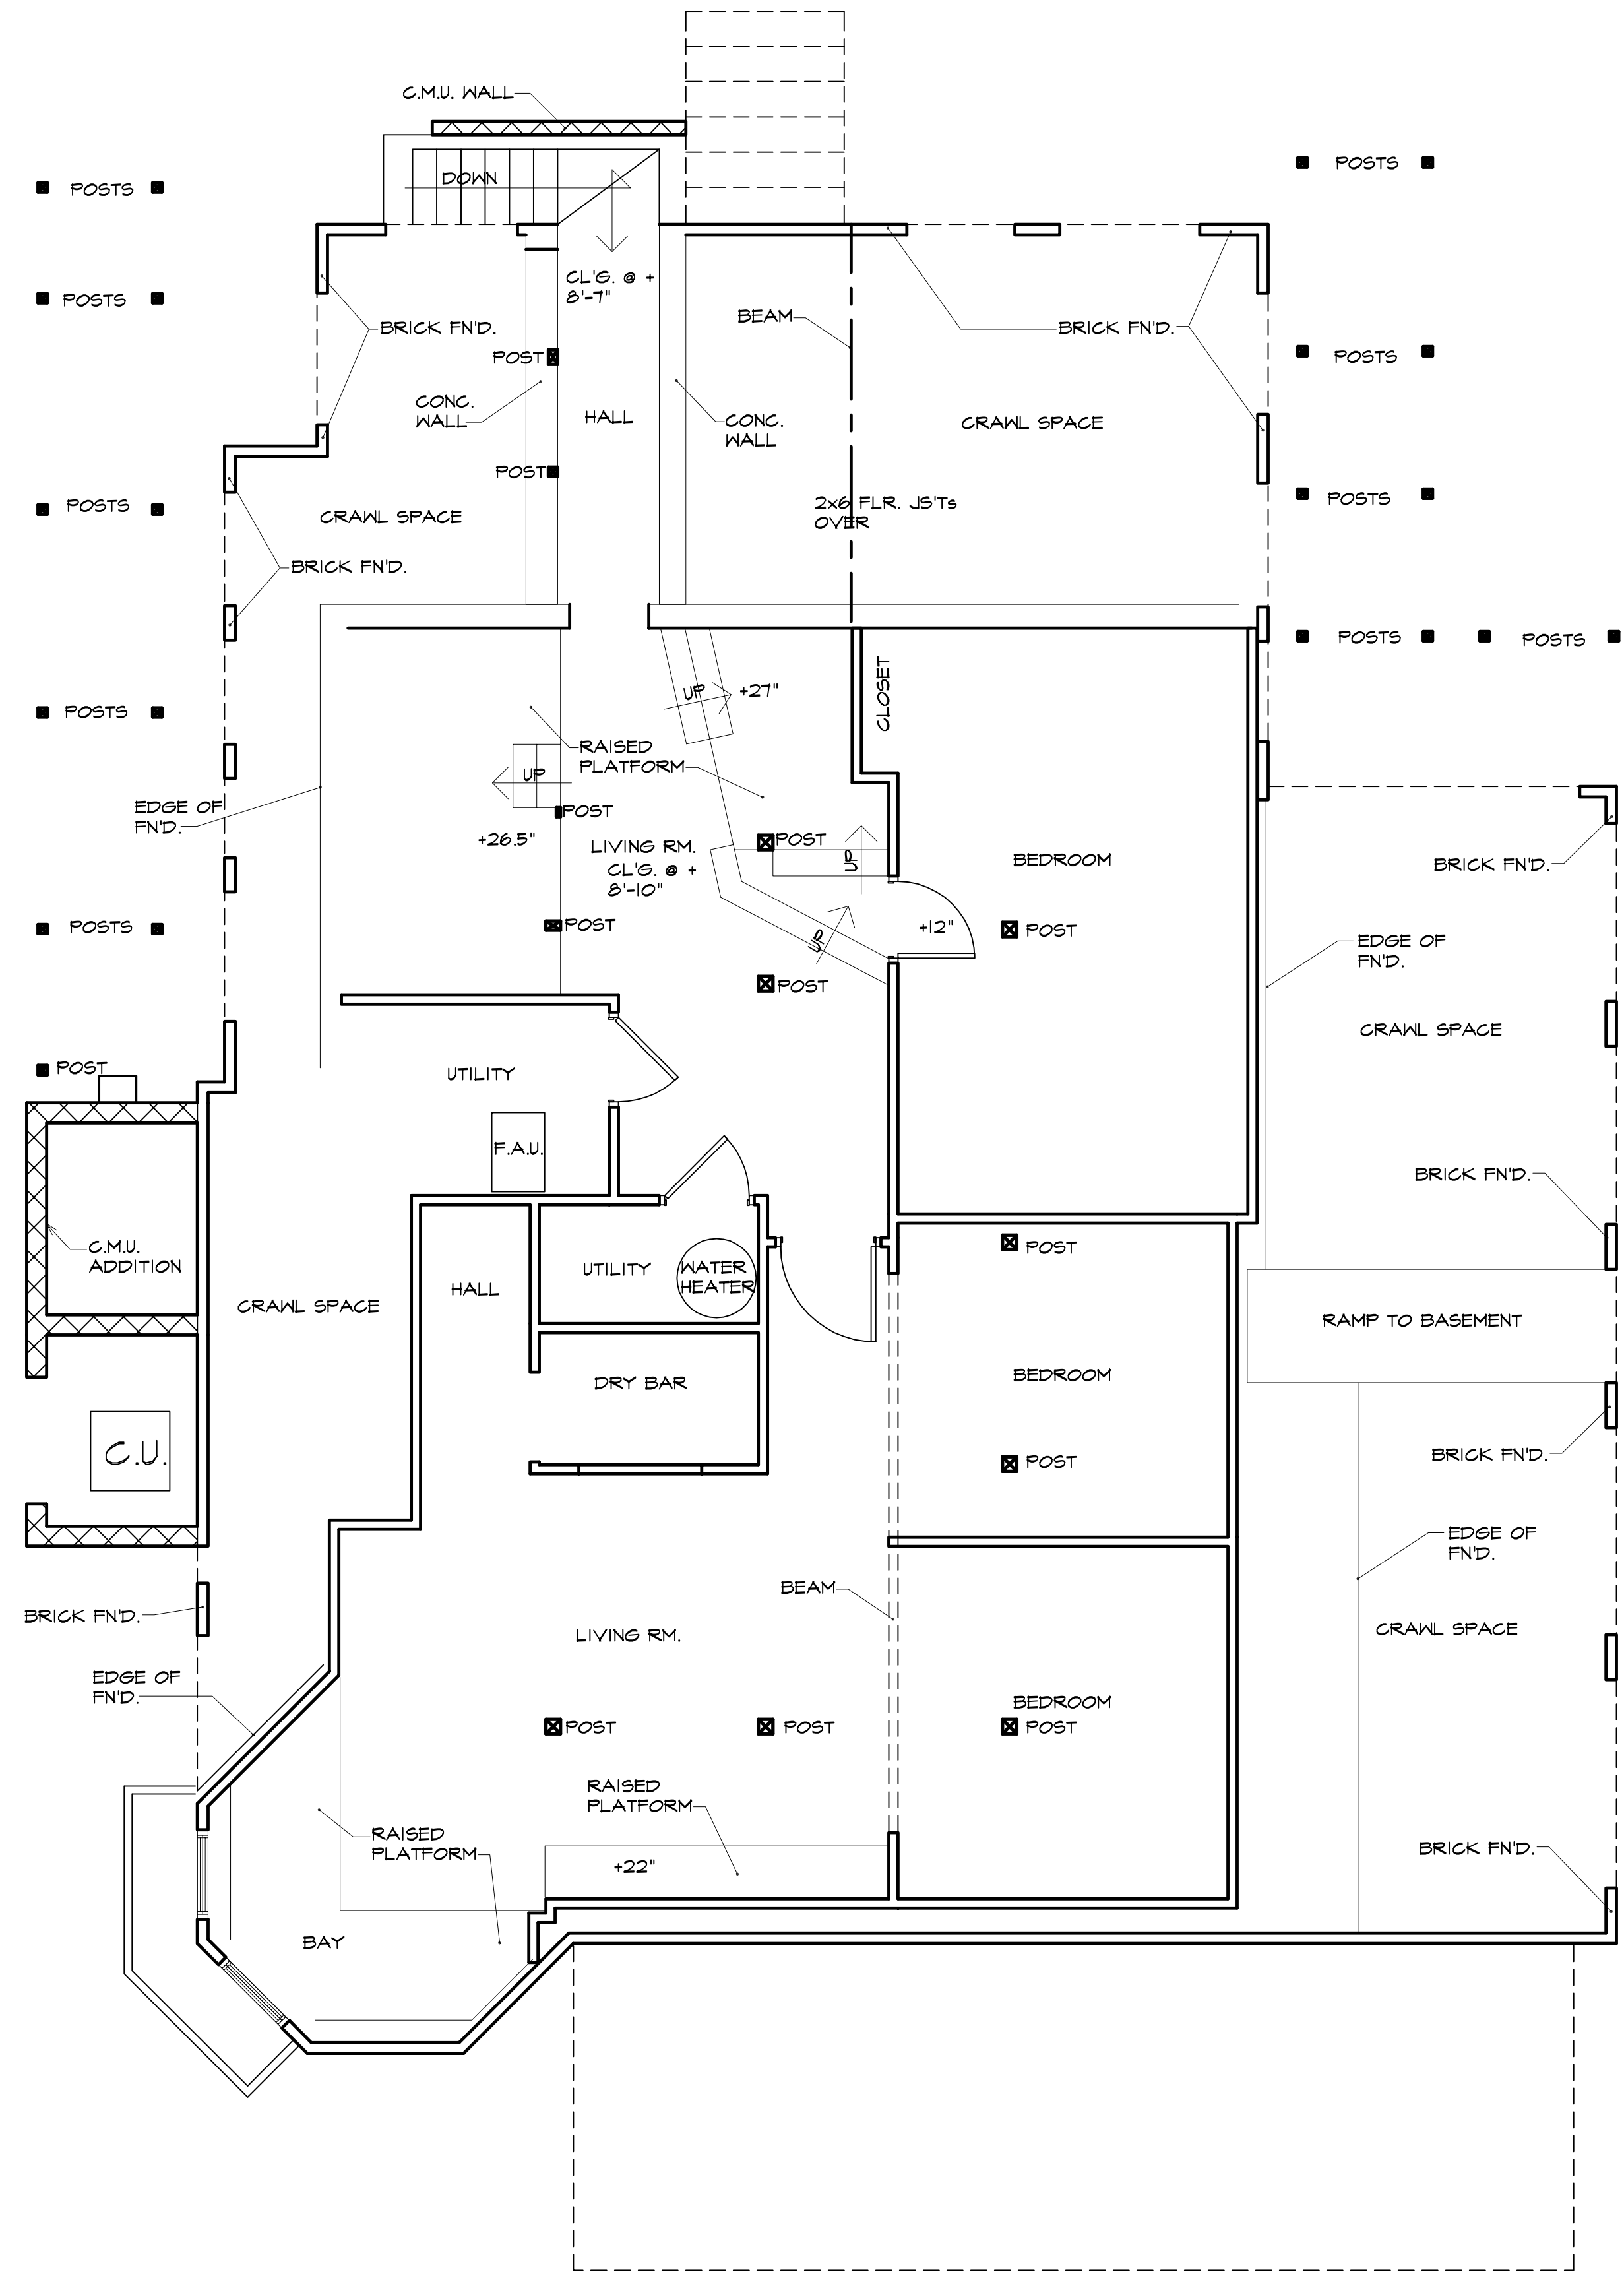


BASEMENT LEVEL FLOOR PLAN

Revisions:	Date:	By:

GREGORY A. PEITZ
ARCHITECT
383 Rio Lindo Ave. Chico, CA. 95926 (530) 894- 5719

ROMODEL FRATERNITY HOUSE
THETA CHI
for: 630 WEST 5th. STREET
at: CHICO, CALIF. 95928

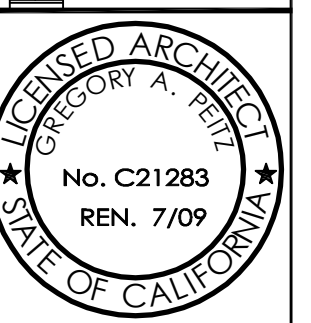

THETA CHI
REMODEL

Date: 12/14/08
Scale:
Drawn: DAVID S.
Job: 08-1292

Sheet:
4
Of three Sheets